

KINGSTON, FRONTENAC AND LENNOX AND ADDINGTON HEALTH UNIT

221 PORTSMOUTH AVENUE, KINGSTON, ONTARIO • CLOYNE, ONTARIO
MEMORIAL BUILDING, DUNDAS ST. W., NAPANEE, ONTARIO • SHARBOT LAKE, ONTARIO

APPLICATION NO.

B-4275

USE PERMIT FOR CLASS 4, 5, 6 SEWAGE SYSTEMS

INSPECTION DETAILS	TIME 225	DATE July 8 1976	WEATHER Raining
REPRESENTING:	THE OWNER		THE INSTALLER

1. Work authorized by the Certificate of Approval has been satisfactorily completed and includes:

- a) Septic tank/holding tank of working capacity of 600 Imp. Gals. constructed of steel ☐ concrete ☒ fibreglass ☐
on site ☐ or prefabricated ☒ to serve 3 (no. of bedrooms or units).

MAKE AND MODEL,


IF PREFABRICATED TANK

Planes Pre Cast Low.

- b) Leaching bed of total 240 lineal feet of 3 inch diameter distribution pipe of PVC
(type and product description e.g. Canron CSA Approved PVC) laid in 5 runs and fed by
gravity (gravity, siphon, pump). (5-30
4-20
1-10)
- c) Proprietary Aerobic System: (Manufacturer) _____ (Model) _____
- d) Other details _____

2. Location

- a) System components installed as shown on application supporting Certificate of Approval ☐
- b) If located other than in (a) use space below for sketch and dimensions from permanent points of reference sufficient to facilitate future location of tank and leaching bed including orientation of pipe runs.

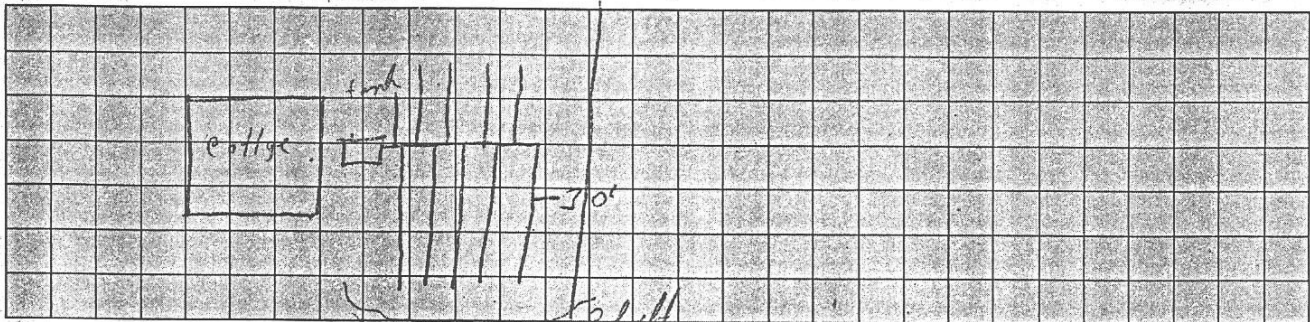

3. The following work remains to be completed:

- ☒ Backfill System and Complete ☐ Finish Grading to Shed Run-off and Divert Water Around Leaching Bed
- ☐ Stabilize All Sloped Surfaces ☒ Other check...grade...on...leaching pipe

Any Use Permit issued hereunder may be revoked if this work is not completed promptly to Provincial standards. 1-1/2" 25

USE PERMIT

Under Section 59a of The Environmental Protection Act, 1971 and subject to the provisions of The Act and Regulations a Permit is hereby issued to (Owner) Walter A. White for the use and operation of the Class 4 sewage system constructed/installed/enlarged/extended/alterd pursuant to the Certificate of Approval issued under the above application number in accordance with the application and Certificate of Approval with any changes indicated above and located on Lot 1 & 2 Concession 13 Ward/Township/Municipality Bedford Region/District/County Frontenac Plan No. R162 Sub-Lot No. 9

INSPECTED AND RECOMMENDED BY

Doug Steele

PERMIT ISSUED BY

D. T. S. for F. Hatchings DIRECTOR

DATE ISSUED

July 8 1976

Note: Section 57(a) of The Act provides that no change can be made to any building(s) or structure(s) in connection with which this sewage system is used, if the operation or effectiveness of the sewage system will or is likely to be affected by the change, unless a new Certificate of Approval is obtained.

Section 78 of The Act provides that an applicant may appeal the imposition of terms and conditions by a Director on issuing a permit. Written notice of appeal must be forwarded to the Director and to the Environmental Appeal Board, 365 Bay Street, Suite 900, Toronto, Ont., M5H 2V3 within 15 days of receipt of the permit.

Expiry Date: Dec. 31/76

S-75

Kingston, Frontenac and Lennox and Addington Health Unit

File No. B-42-75

Date June 3/75

SITE INSPECTION REPORT FOR CERTIFICATE OF APPROVAL
APPLICATION FILE NO. B-42-75 DATED June 4/75

Distribution

- Copy 1 — Owner
Copy 2 — Office
Copy 3 — Contractor

Owner's Name Walter A. White Lot No. 142 Con. 13 Township/Ward Red Fox

1. Persons at inspection: Name(s) Walter White
Attending in capacity of owner

2. Time of Inspection 11 am Weather Conditions cloudy & rain

3. Assessment of Proposal

a) Change(s) to proposal required (yes) or (no) due to: (Record details of change in Item 4

- i) Surface Drainage 0.5 ii) Slope of Ground 2.7%
iii) Presence of Rock 3 approx iv) Impervious Soil no
v) High Water Table 6.0 vi) Clearances (Horiz.) 0.5

b) Percolation Rate $t = \frac{10}{20}$ Mins: Measured ☐
Estimated ☒

SOIL CONDITIONS ENCOUNTERED

Level	Soil Type
0	sandy with stones
1	
2	
3	rock
4	
5	
Show Rock Elevation <u>3.5</u>	
High Water Table — GWT <u>V</u>	

4. Requirements of System

- a) Working Capacity (Imp. Gals.) of Septic Tank 600 or Holding Tank 240
b) Length of Absorption Trench Required 240 feet.
c) Changes Required — (For granular fill give area and depth)
Include sketch(s) if required to show change(s).

Fill and grade the leaching bed area to create a level area with 5' of earth from the bedrock to the finish grade. Install leaching trench as per our regulations.

5. Decision: The proposal is:

- a) Acceptable in accordance with the application. ☐
b) Not acceptable ☐ Record reason in space above.
c) Acceptable if required changes in Item 4 are carried out. ☐
d) Not acceptable but owner may wish to consider a
— Proprietary Aerobic System ☐ — Holding Tank ☐

6. Class 4 Certificate of Approval issued
on June 17/75 (Date)

Dorey Steele
Inspector

APPLICATION FORM AND CERTIFICATE OF APPROVAL FOR A CLASS 2-6 SEWAGE SYSTEM

(PLEASE PRINT CLEARLY)

APPLICATION NO. B-42-75

FEE:

RECEIPT NO. 25.00 (cheque)

DATE RECEIVED Jun 3/75

1. Name of Owner WALTER A. WHITE Tel.No. 389-1588 2. Installer's Name ROBERT PHILLIP Tel.No. 395-2420

Address 310 OLYMPUS AVE
(NO., STREET,
CITY, TOWN, ETC.) KINGSTON ONT

Address CARPENTER
(NO., STREET,
CITY, TOWN, ETC.) STERLING ONT

3. Propose to Construct a Class 2 sewage system to serve SINGLE
(CONSTRUCT/INSTALL/ALTER
EXTEND/ENLARGE) (TYPE OF BUILDING(S); E.G. SINGLE
FAMILY DWELLING, RESTAURANT,
MOTEL, TRAILER PARK)

4. Location-REGION, COUNTY, DISTRICT BUCK-LAKE BLUE WATER PARKS WARD, TOWNSHIP, TOWN BEDFORD-TWSP LOT NO. 112 CONC. NO. 13 SUB LOT NO. PART 2 PLAN NO. R162 AREA OF LOT (SQ. FT.) 23,000

5. State Number of	BEDROOMS OR MOTEL UNITS <u>3</u>	PEOPLE <u>5</u>	FLUSH TOILETS <u>1</u>	URINALS <u>N/A</u>	WASHBASINS <u>.</u>	SHOWERS AND BATHTUBS <u>N/A</u>	6. Water Supply
LAUNDRY TUBS <u>N/A</u>	KITCHEN SINKS <u>1</u>	GARBAGE GRINDERS <u>N/A</u>	DISHWASHERS <u>N/A</u>	AUTOMATIC WASHERS <u>N/A</u>	OTHER (STATE) <u>?</u>		☐ DUG OR DORED WELL ☐ DRILLED WELL ☐ MUNICIPAL ☒ PROPOSED ☐ EXISTING

7. Attach completed sketch (MOE 14-248)-List other attachments:

TWO SKETCHES (PHOTO-COPIES) attached

8. Relationship to Severance if applicable ☐ LOT APPROVAL PENDING ☒ LOT APPROVED UNDER SEVERANCE APPLICATION NO. 9. Directions to Lot: HIGHWAY NO., SECONDARY ROADS, SIGNS TO FOLLOW, ETC.
Take Westport Rd. north from Kingston (Division 1)
Turn approximately 3 1/2 miles south Westport Rd.
Blue Water Park Development sign - follow
Bowes & Cochrane Cottage signs - approximately 5 mi

10. I certify that the above information is complete and correct and that, if approved the work will conform with Provincial requirements for sewage systems and local Municipal By-Laws. (Attach fee for Class 4, 5 or 6 systems)

NAME OF AGENT W. A. White TEL. NO. 389-1588 SIGNATURE OF OWNER OR AGENT W. A. White
ADDRESS 310 OLYMPUS AVE DATE MAY 30/75
(NO., STREET,
CITY, TOWN, ETC.)

1. INSPECTOR'S REPORT		INSPECTION TIME AND DATE ____ O'CLOCK ____ 19__		SOIL CONDITIONS ENCOUNTERED	
WEATHER	REPRESENTING OWNER	LEACHING BED AREA DEPTH (FEET) TO ROCK	WATER TABLE	WATER TABLE OR ROCK	ELEVATION
					0 1 2 3 4 5
REQUIREMENTS	WORKING CAPACITY OF SEPTIC/HOLDING TANK IMP. GALS.	LENGTH DISTRIBUTION PIPE LINEAL FT.			

Other Requirements and Comments (E.G. FILL, GRADING, DRAINAGE IMPROVEMENTS, DESIGN SEWAGE FLOWS)

12. Proposal Not Accepted Due to: